699

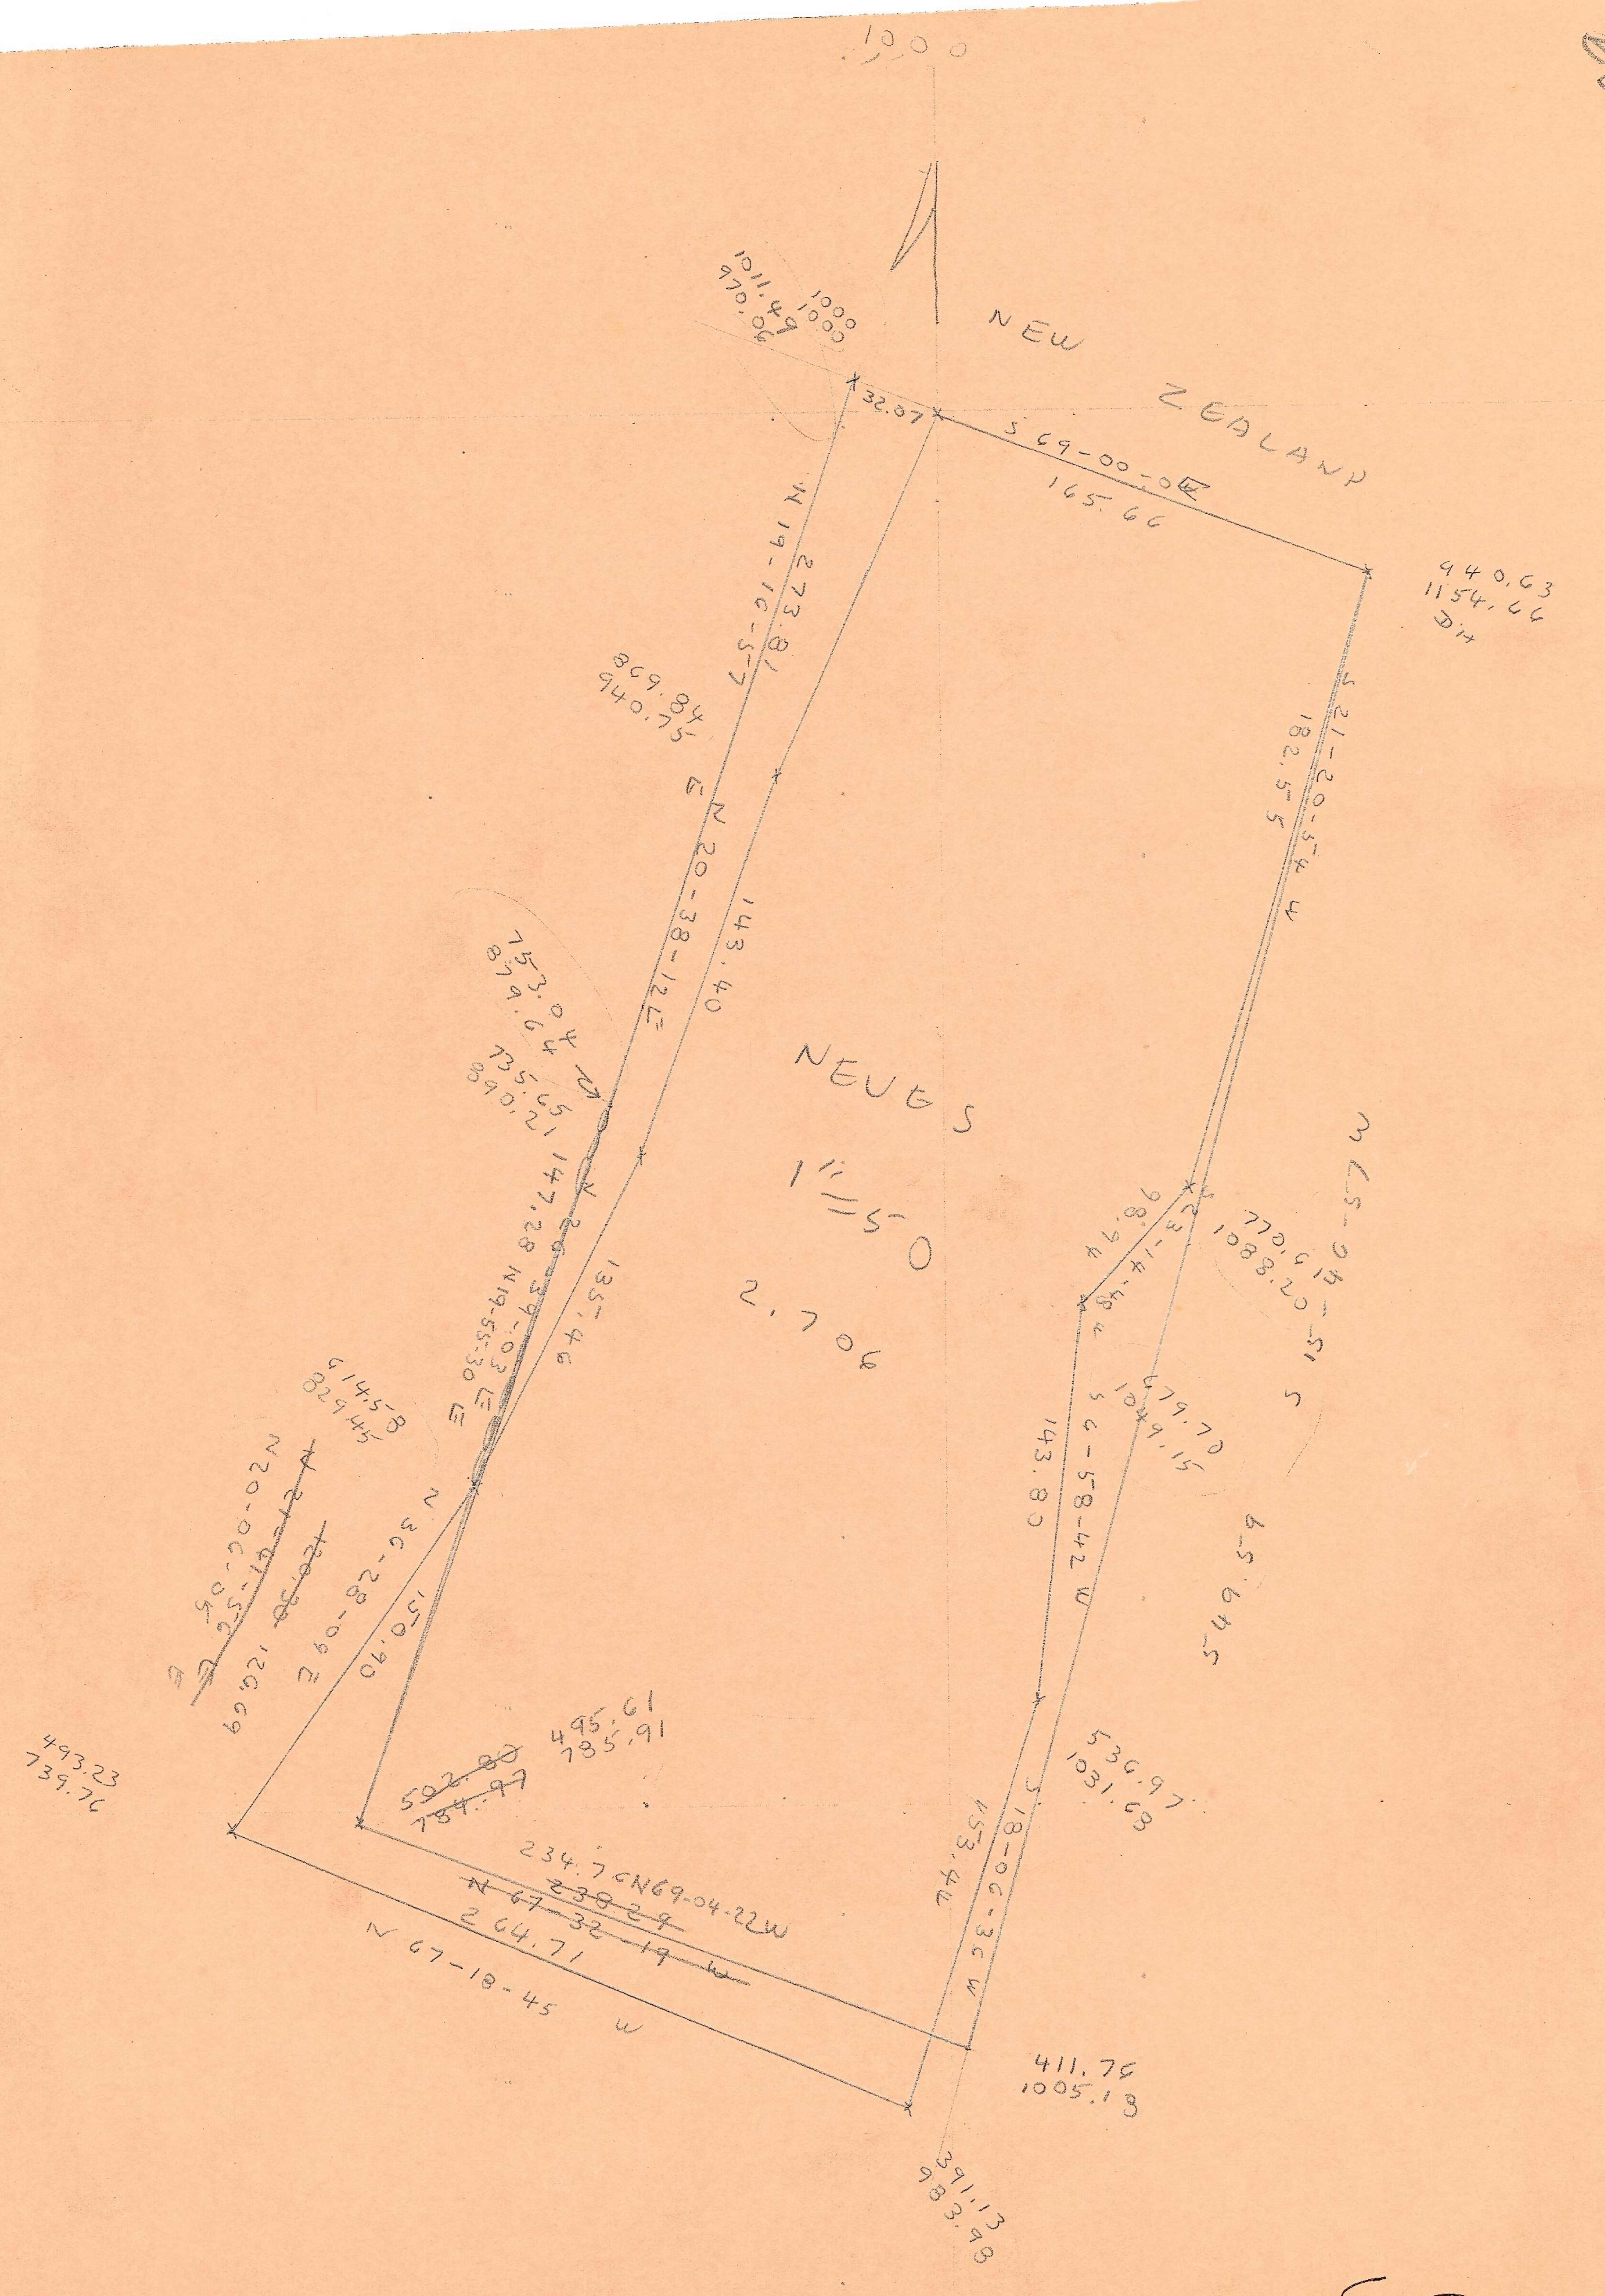
1000
1011.49
970.06
1000
1000
NEW ZEALAND
32.07
S 69-00-00E
165.66
940.63
1154.66
D.H
N 19-16-57
273.81
869.84
940.75
N 20-38-12E
143.40
753.04
879.64
735.65
890.21
147.28 N19-55-30E
135.46
NEVES
1" = 50
2.706
914.58
829.45
N 36-28-09E
150.90
~~N 20-06-05~~
~~125.12~~
126.69
493.23
739.76
~~592.80~~
~~789.97~~
495.61
785.91
234.76 N69-04-22W
~~238.29~~
~~N 67-32-19 W~~
264.71
N 67-18-45 W
98.94
S 23-14-48
779.614
1088.20
S 21-20-54 W
182.55
S 15-46-57 W
143.80
S 24-58-42 W
679.70
1049.15
549.59
536.97
1031.68
S 18-06-36 W
153.44
411.75
1005.13
391.13
983.98

699

699

PLAN OF LAND
SEABROOK, N.H.
RUTH NEVES
SCALE 1" = 50'   AUG. 1969
PARKER SURVEY ASSOC. INC. SEABROOK, N.H.

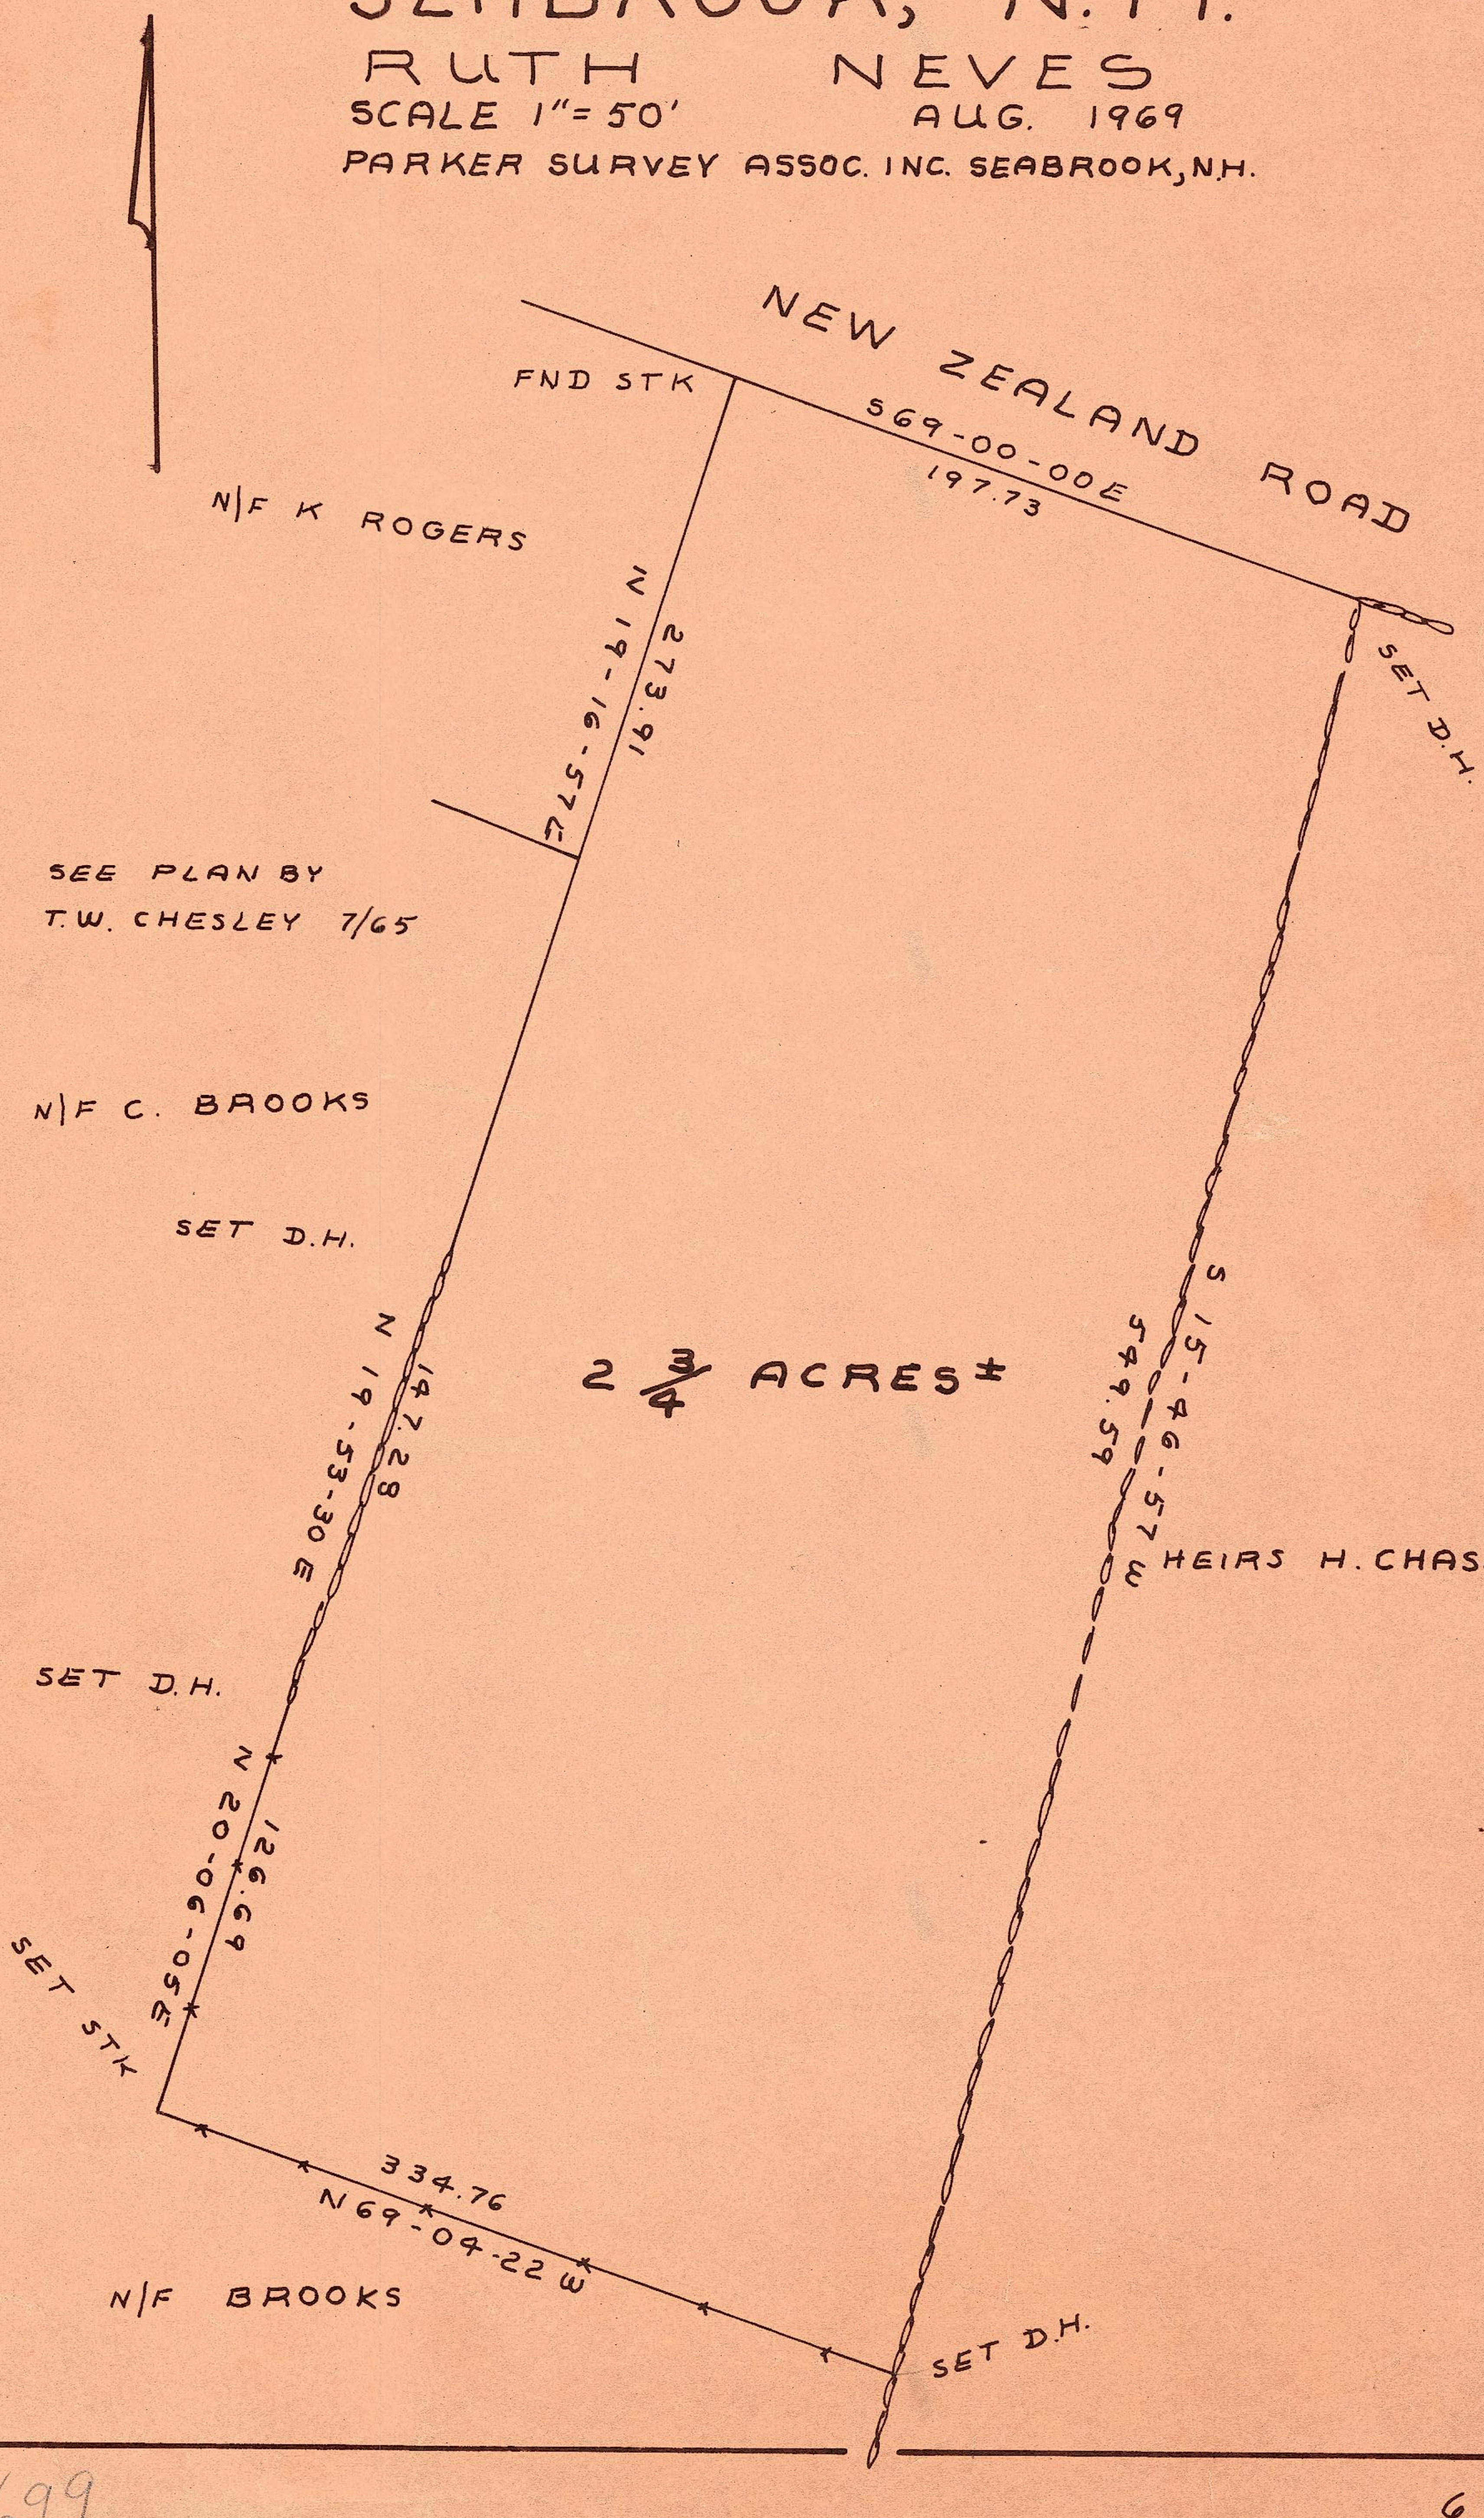
NEW ZEALAND ROAD
FND STK
S69-00-00E
197.73
N/F K ROGERS
N 19-16-57E
273.91
SET D.H.
SEE PLAN BY
T.W. CHESLEY 7/65
N/F C. BROOKS
SET D.H.
N 19-53-30 E
147.28
2 3/4 ACRES ±
S 15-46-57 W
549.59
HEIRS H. CHASE
SET D.H.
N 20-06-05 E
126.69
SET STK
334.76
N69-04-22 W
N/F BROOKS
SET D.H.

699

699